B.C. LAND SURVEYOR'S BUILDING HEIGHT SURVEY CERTIFICATE COVERING PART OF LOT 1 SEC 11 TP 1 NWD PLAN BCP15882


SCALE 1:500


The intended plot size of this plan is 280mm in width and 432mm in height (B size) when plotted at a scale of 1:500.

ROPER AVENUE



KEY PLAN

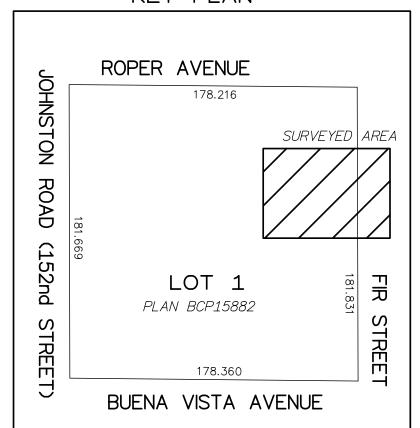

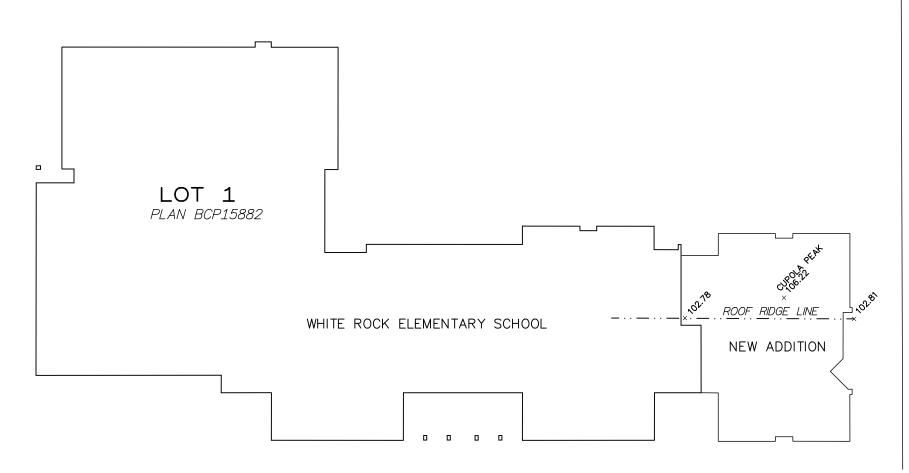

CERTIFIED CORRECT DATED THIS 19th DAY OF January, 2023.

B.C.L.S.

M. Adam Fulkerson

CIVIC ADDRESS:

P.I.D. 026-188-899

1273 FIR STREET, WHITE ROCK, BC

White Rock Elementary School

THIS DOCUMENT IS NOT VALID UNLESS ORIGINALLY SIGNED AND SEALED BUILDING OFFSETS SHOWN ON THIS PLAN ARE NOT TO BE USED TO RE-ESTABLISH PROPERTY CORNERS

Measurements shown are to the as-built roof ridge.

Lot dimensions are derived from Plan BCP15882.

Elevations are Geodetic (CVD28 GVRD-2005 - IN METERS) Derived from Control Monument 88H3900 located at the Southeast corner of intersection of Buena Vista Avenue & Fir Street. Elevation = 82.581m

All rights reserved . No person may copy, reproduce, transmit or alter this document in whole or part without the consent of the signatory.

The signatory accepts no responsibility or liability for any damages that may be suffered by a third party as a result of any decisions made, or actions taken based on this

This document shows the relative location of surveyed structures with respect to the boundaries of the parcel described above.



五

S

TREE

FILE: 8117-ROOF-CER © TARGET LAND SURVEYING 2023